


#14688-91, 25.Feb.19:
Pre ER mark-up.
Thanks, Will

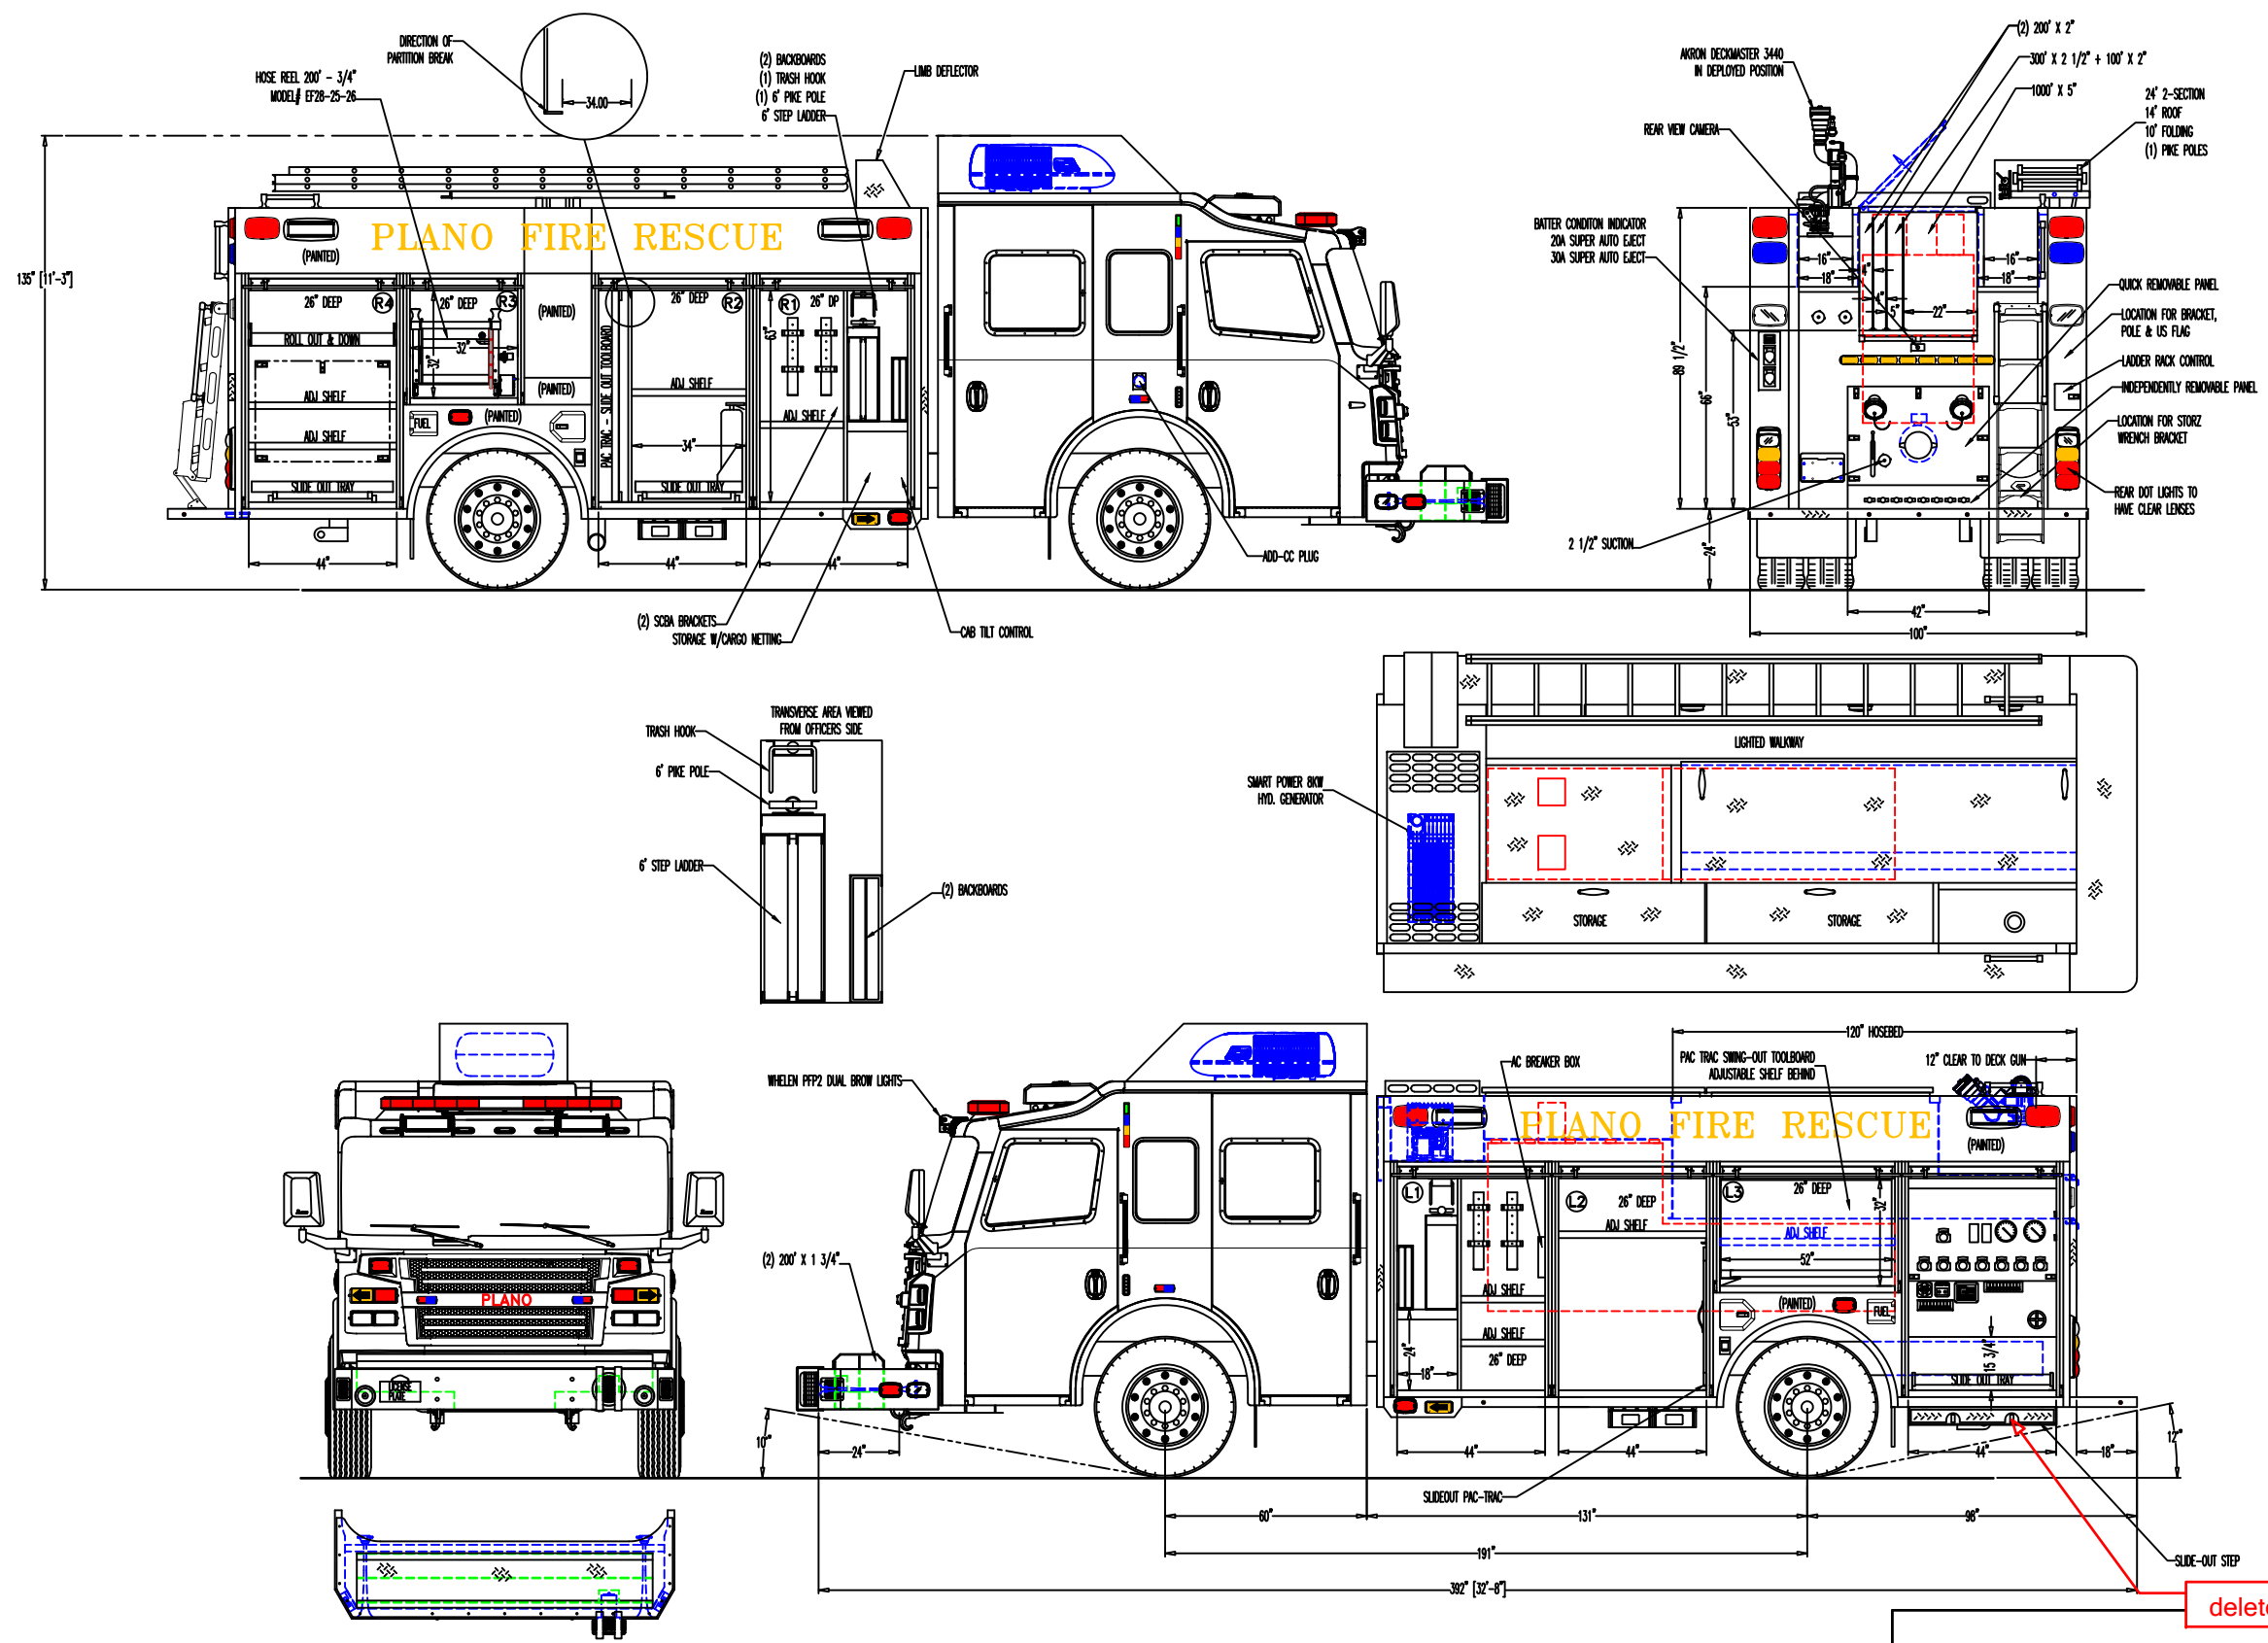

delete this slide-out step.

- NOTES:
1. OVERALL HEIGHT IS IN LOADED CONDITION. UNLOADED HEIGHTS MAY BE 4" ABOVE HEIGHTS SHOWN.
 2. DO NOT SCALE DRAWING.
 3. ALL DIMENSIONS ARE APPROXIMATE AND SUBJECT TO ENGINEERING CHANGES.
 4. DRAWING MAY OR MAY NOT SHOW ALL ITEMS AS DESCRIBED IN THE WRITTEN DETAIL SPECIFICATIONS.
 5. INCLUSION OF AN ITEM ON THE DRAWING DOES NOT CONSTITUTE INCLUSION OF THAT ITEM WITH THE FINAL DELIVERED UNIT.

REVISED: -	DATE: -
REVISED: TAA	DATE: 02-18-2018 (H-00)
REVISED: CBL	DATE: 07-12-2018 (H-00)
DRAWN: CBL	DATE: 06-02-2018 (P-786-00)

PROPRIETARY AND CONFIDENTIAL
THE INFORMATION CONTAINED IN THIS DRAWING IS
THE SOLE PROPERTY OF ROSENBAUER. ANY
REPRODUCTION IN PART OR AS A WHOLE WITHOUT
THE WRITTEN PERMISSION OF ROSENBAUER IS
PROHIBITED.

APPROVED BY:

MAXIMUM HEIGHT	NONE
MAXIMUM LENGTH	NONE
BODY WIDTH	100"

CHASSIS: ROSENBAUER R6011
PUMP: WATEROUS S100D/C20 1500 GPM
TANK: POLY 500 / 30 (FOAM)
TYPE: REARMOUNT PUMPER
AERIAL: N/A

PLANO FIRE DEPARTMENT

ROSENBAUER EXT

14688-91	P6965	03
----------	-------	----